


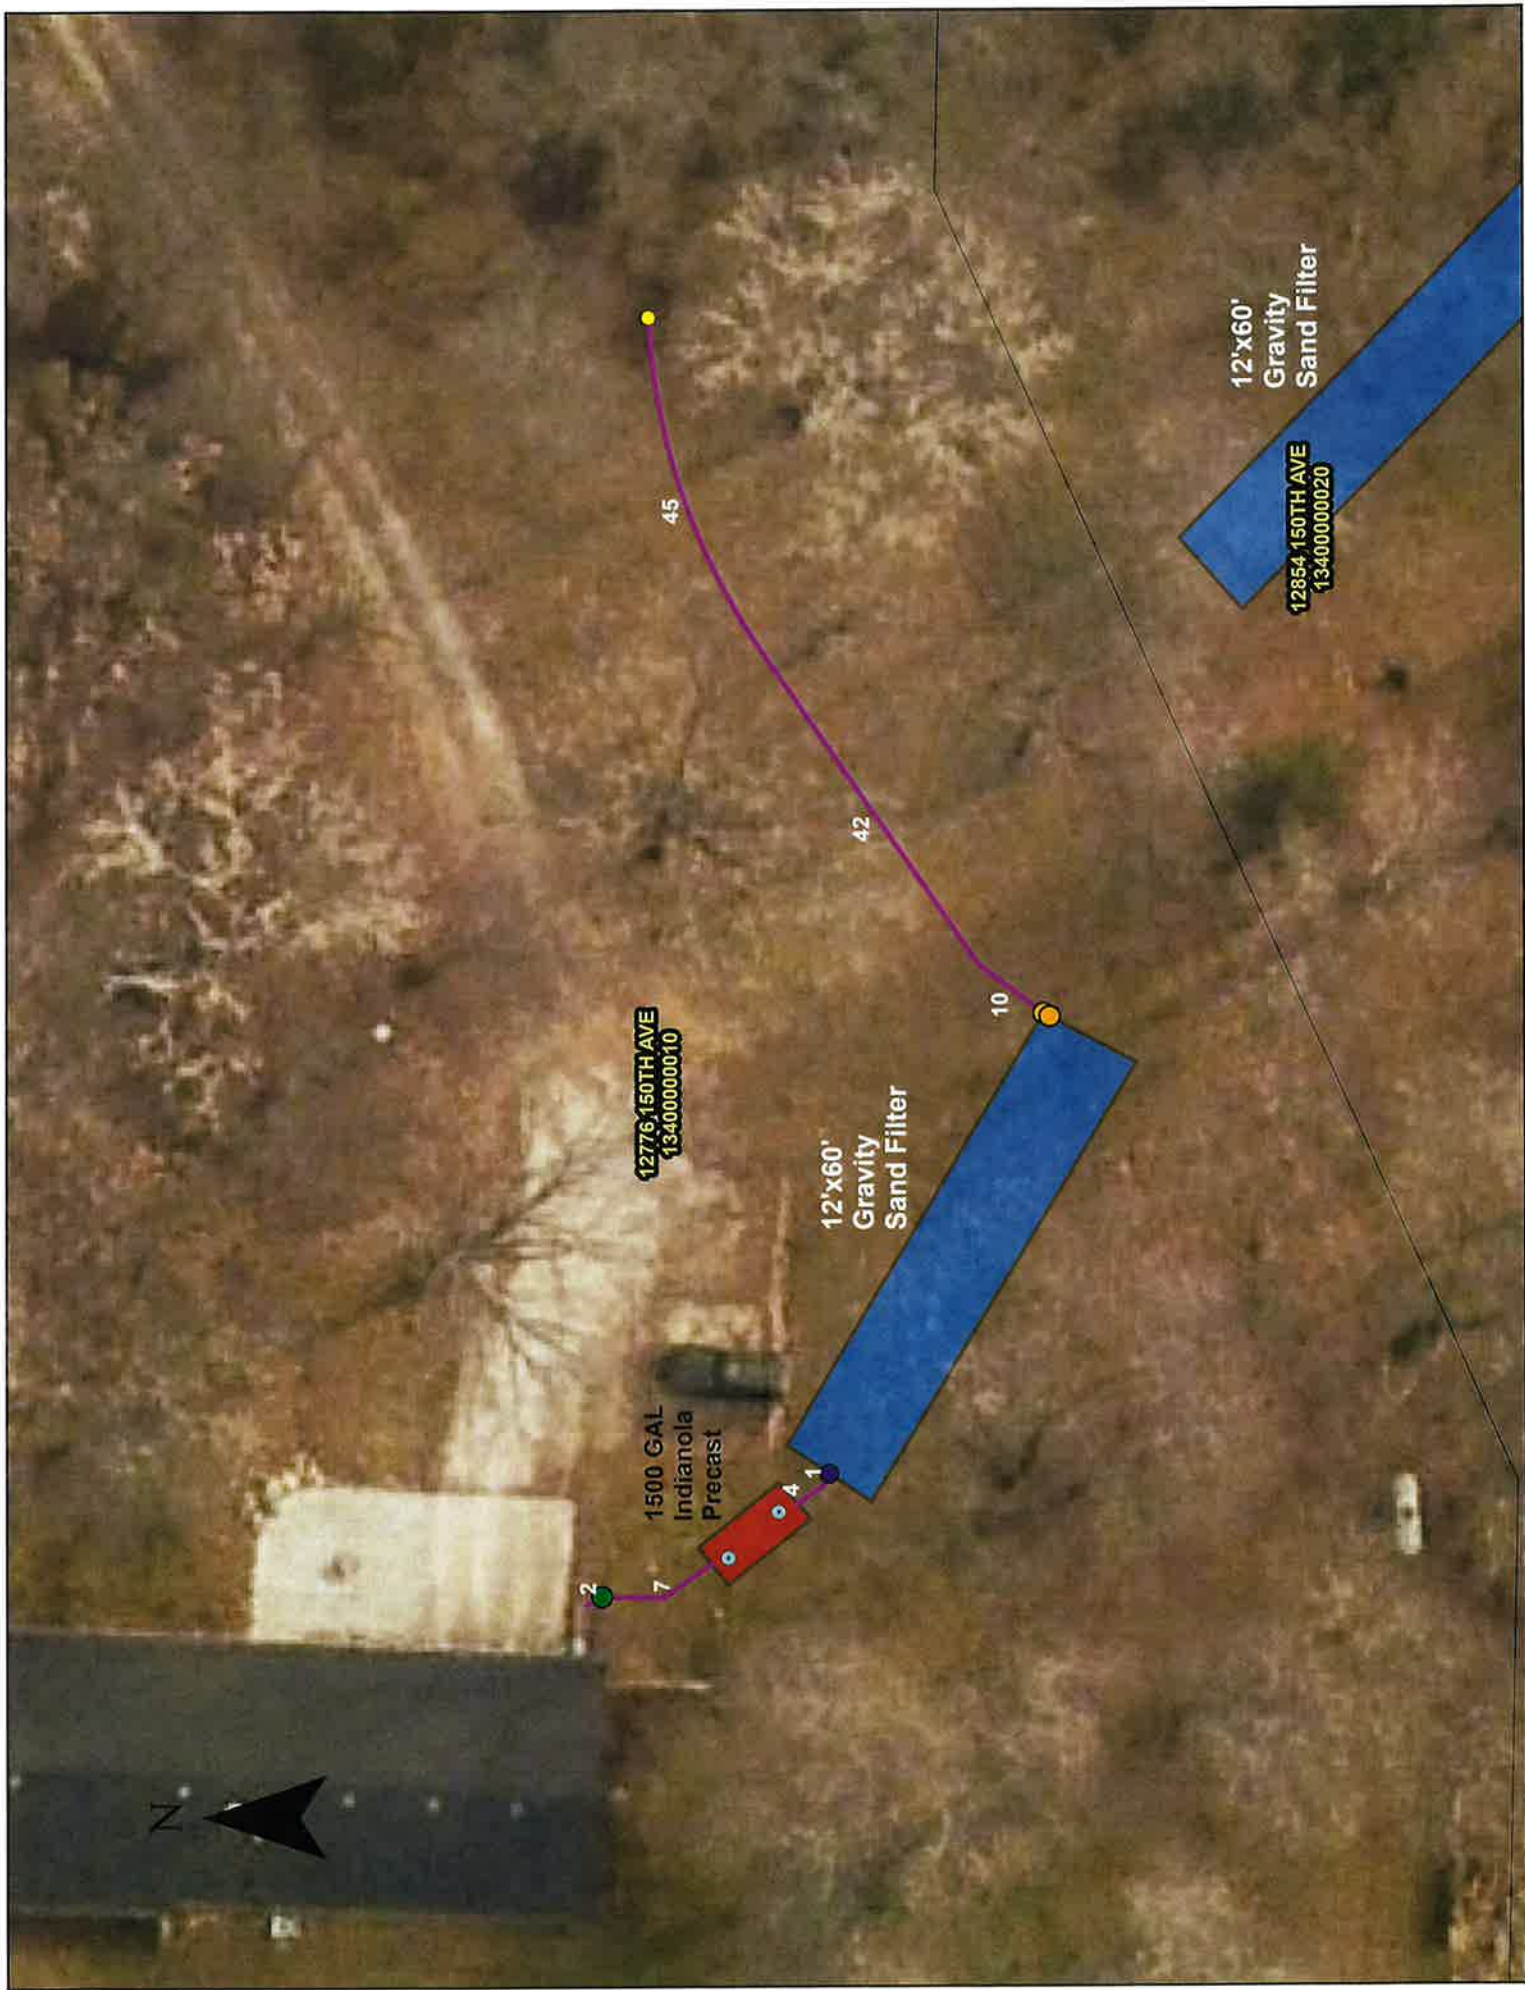

Permit # 2025-90	WARREN COUNTY ENVIRONMENTAL HEALTH 301 N Buxton, Ste. 203, Indianola, IA 50125 Phone: (515) 690-9190 - Email: EnvHealth@warrencountyia.org	Permit Fee: \$300.00 Date Paid: 07/15/2025
PRIVATE SEWAGE DISPOSAL SYSTEM PERMIT A permit is required prior to conducting any change that affects the treatment or disposal of the waste, including replacement of the primary or secondary components, or a change in the design of the permitted private sewage disposal system from the design that was originally installed and approved by the administrative authority. This non-transferable permit is valid for ONE YEAR.		

Owner Information (Applicant)			Installation Contractor Information		
Name DALBY, STANLEY B/SHIRLEY R (Deed)			Name Mike Killen		
Mailing Address 12776 150TH AVE			Address 1679 140th Ave		
City INDIANOLA	State IA	Zip 50125	City Carlisle	State IA	Zip 50047
Phone Number 5154806082			Phone Number 515-480-6082		
Email:			Certification #: 501280		
Site Information					
Site Address: 12776 150TH AVE			Parcel #: 13400000010		
Legal Description: 32-76-23 JOHNSON SUB DIV LOT 1					
S/T/R:					
Dwelling/Building Information					
Building Type: ☐ New ☒ Existing	Purpose: ☒ House ☐ Accessory Building ☐ Business	Septic Construction Type: ☐ New System ☒ System Replacement ☐ Repair - Tank or D-Box ☐ Repair - Treatment Area	PERCOLATION/SOILS ANALYSIS MUST BE COMPLETED AND APPROVED PRIOR TO THE ISSUANCE OF PERMIT Attach Report		
Number of Bedroom: 3			For A Business – What type? Single		
Private Sewage Disposal System Design					
Soil Report	Engineer: James Carroll	SA Date: 07/03/2025	SA Expire Date: 07/03/2026		
Tank	Type:	# of Tanks: 1	Size: 1250		
Secondary Treatment Area					
☐ Laterals: Feet Required _____ for _____" Wide Trench _____ Max Trench Depth ☒ Sand Filter ☐ At-Grade ☐ Mound			☐ Waterloo Biofilter ☐ Enclosed System ☐ Other: _____		
Conditions of the Permit					
1. Maintain All Setbacks					
2. Schedule 40 plastic pipe or EPS aggregate is required.					
3.					

I hereby attest the truth and accuracy of all facts and information presented on this application. Request for inspection of the system must be made 24 hours in advance. Water at the site to test the distribution box/pump dose/siphon dose must be available. Electrical at the site (no generators) to test the pump must be available. If required, a maintenance agreement must be filled with our office prior to issuance of this permit.		It is unlawful to start construction, reconstruction, or repair of any Septic System prior to issuance of a Septic System permit by the Environmental Health Department.
Applicant Signature: Tyler Till - Keyed in by Staff	Date: 07/15/2025	
Issued by: Tyler Till	Date: 07/08/2025	

WARREN COUNTY ENVIRONMENTAL HEALTH SEPTIC INSPECTION REPORT – SAND FILTER
(With IAC Ch. 69 Section 567 and Warren Co. code Ch. 31 References)

General Information

Owner: DALBY, STANLEY B/SHIRLEY R Installer: Mike Killen Construction
Address: 12776 150TH AVE
Inspection Date/s: 07/10/2025 Inspected by: TylerTWC (Tyler Till)
07/11/2025

System Materials: Rock and Pipe ☒ EPS Aggregate ☐

Sewer Pipe from Building to Primary Treatment

Sewer Pipe was installed in accordance with Chapter 69.7(1)-(3) & 69.9(1)g: Yes ☒ or No ☐
If no, explain _____

Septic Tank

Septic Tank Size ☐ 1250 ☒ 1500 ☐ 1750 ☐ 2000 Other _____ Material: ☒ Concrete
☒ septic tank only ☐ Plastic
☐ +500 gallon pump /siphon combination tank
☐ + Separate _____ gallon pump/siphon tank Source: Indianola Precast
Septic tank was installed in accordance with Chapter 69.8(2)- 69.8(3): Yes ☒ or No ☐
If no, explain _____

Connection (Tank-to-box/filter bed) and Distribution Box

Piping between tanks/after tank was installed according to Chapter 69.13(3): Yes ☒ or No ☐
If no, explain _____
Distribution Box was installed according to Chapter 69.13(3): Yes ☒ No ☐ or N/A ☐
If no, explain _____

Siphon Dose and Pump Systems

Siphon or Pump dosing system was installed according to Chapter 69.13(5): Yes ☐ No ☐ or N/A ☒
If no, explain _____
High water alarm ☐ at tank or ☐ inside home
Squirt test Height _____ inches or pumps to distribution box _____

Construction Specifications

Sand filter Type: ☒ Gravity ☐ Siphon Dose ☐ Pressure Dose Bed Dimension 60' ☒ 12'
of Collector lines 2 # of Distribution Lines 4 NOI Required Yes ☐ or No ☒
Discharge Type: ☐ Direct or ☒ Indirect
Sand Filter was installed in accordance with Chapter 69.13(2-3): Yes ☒ or No ☐
If no, explain _____

Minimum Distances for Closed and Open Portions of Treatment System

Both open and closed portion the the septic system have been installed in accordance with the minimum distances listed in Table 1 of Chapter 69.3(2): Yes ☒ No ☐
If no, explain _____

Final Review: ☒ Approved ☐ Approved with Conditions ☐ Disapproved

Approval Conditions: